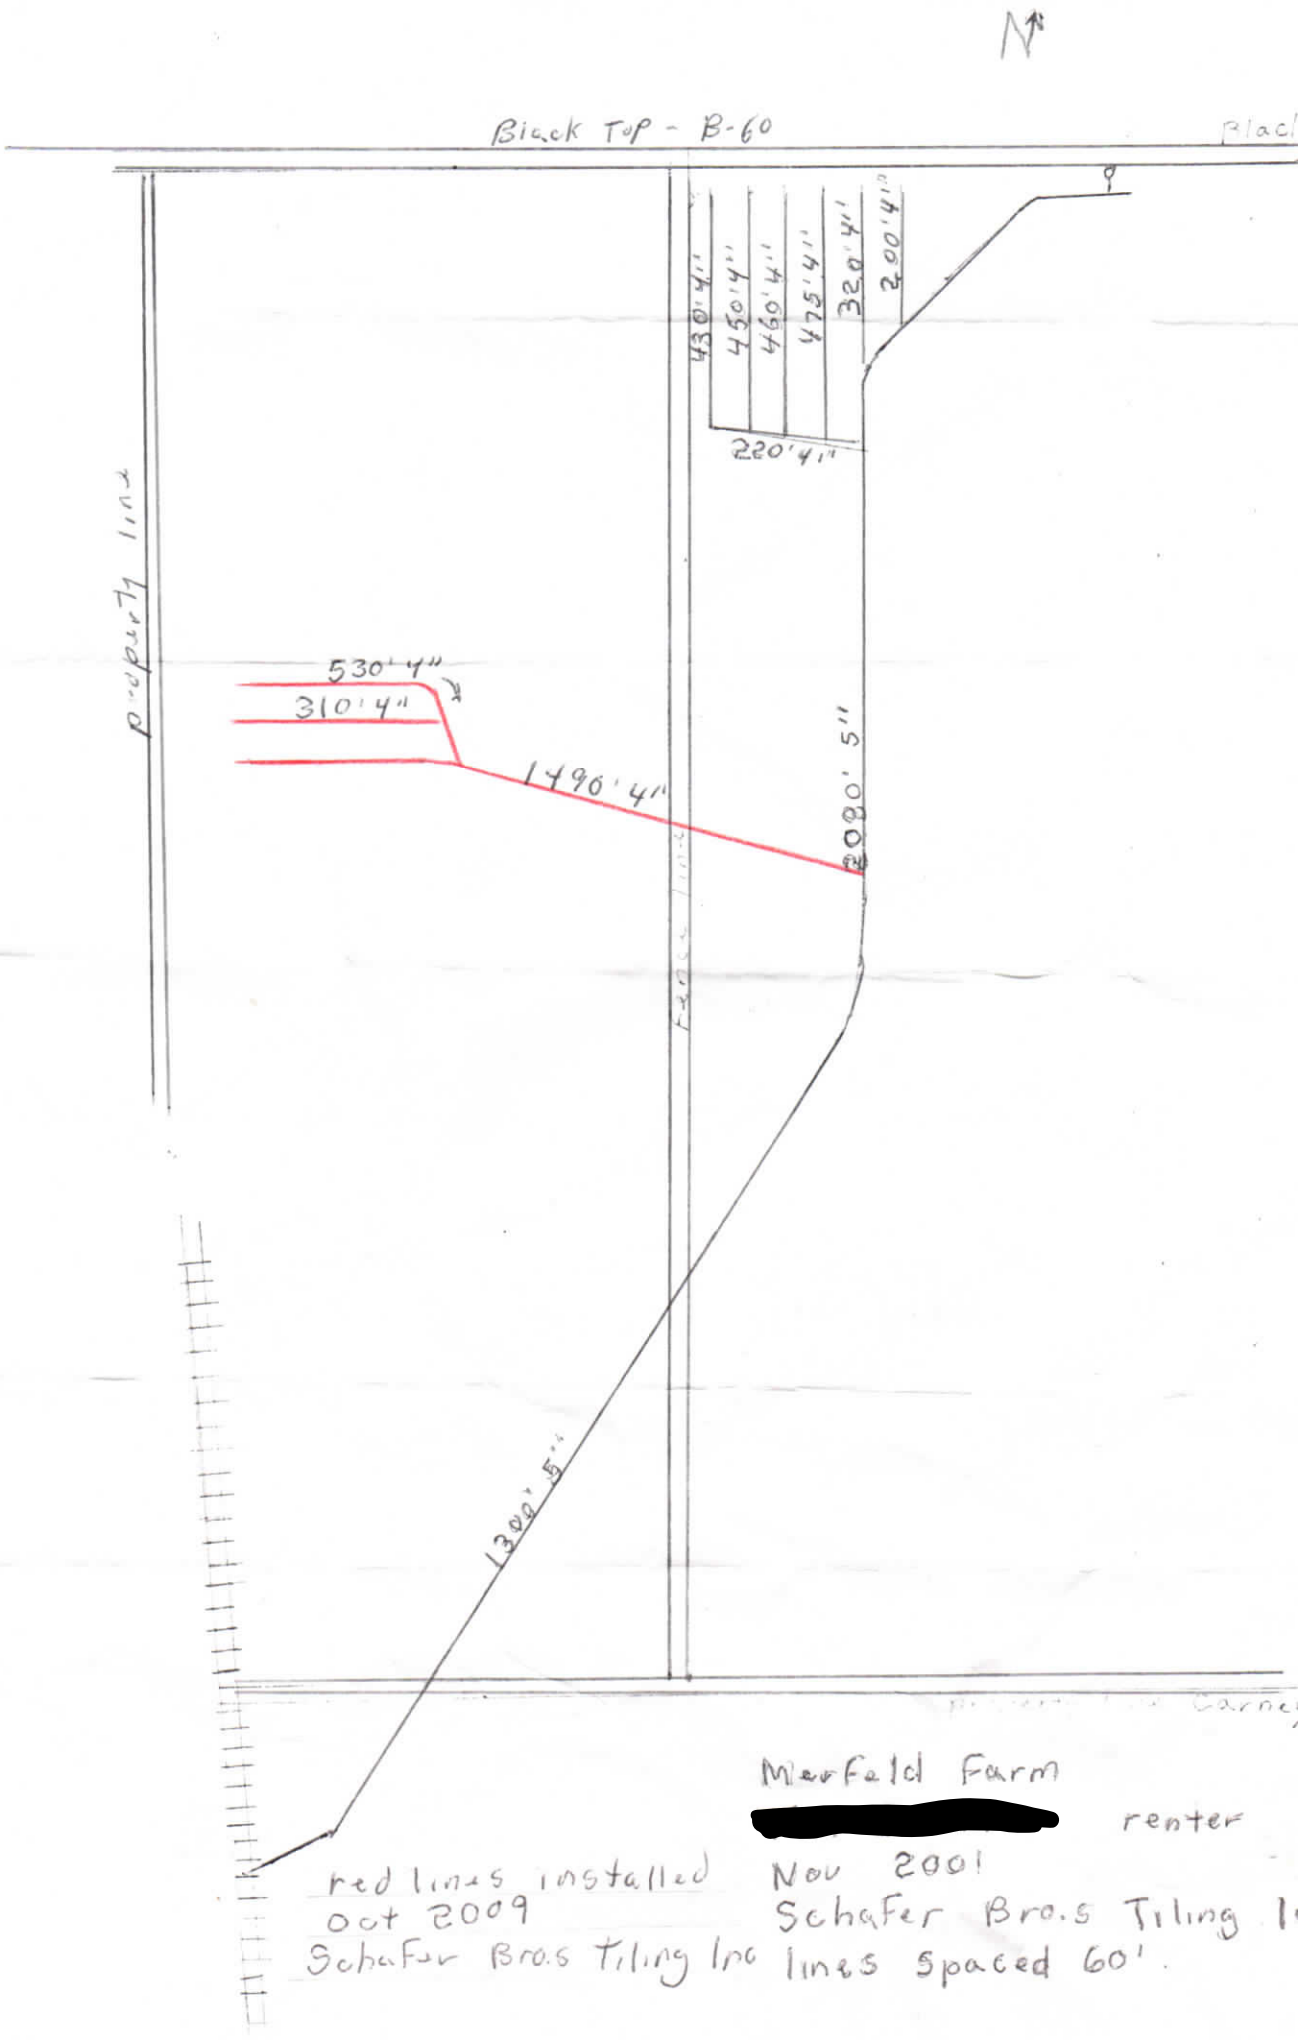


Merfeld Farm

[redacted] renter

red lines installed Nov 2001
Oct 2009
Schafer Bros Tiling Inc
Schafer Bros Tiling I
lines spaced 60'.